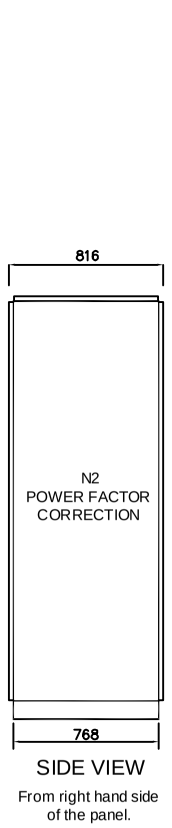

SIDE VIEW

From right hand side of the panel.

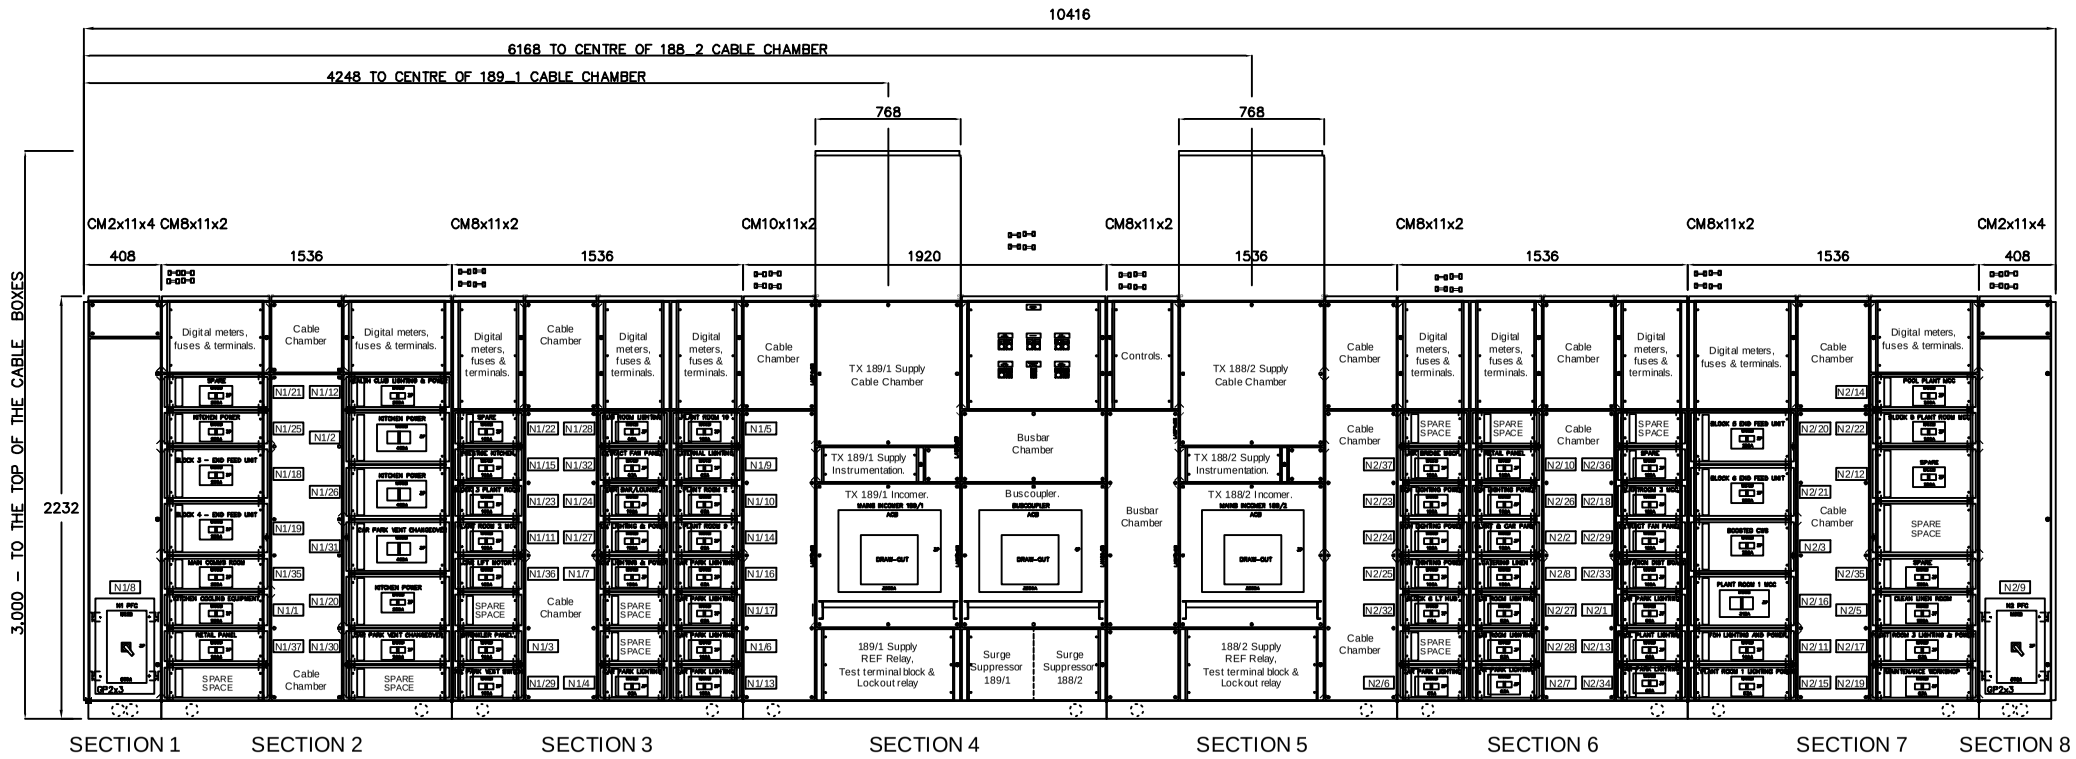

FRONT VIEW

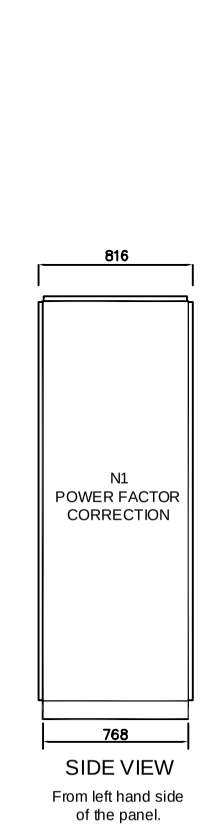

SIDE VIEW

From left hand side of the panel.

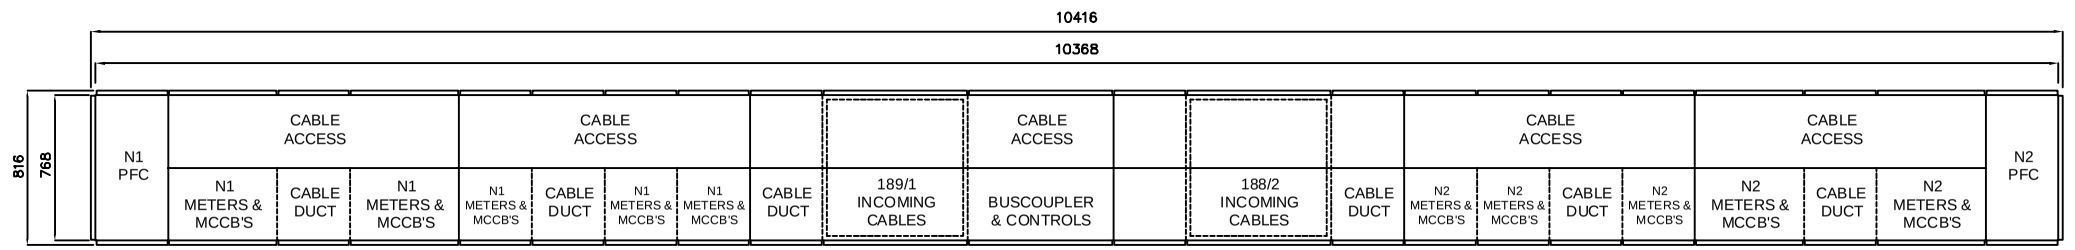

PLAN VIEW

KEL_XX_XX_GA_EL_533001

kane

THIS DESIGN IS THE PROPERTY OF KANE ENGINEERING LIMITED AND MUST NOT BE LENT OR COPIED WITHOUT THE PERMISSION OF KANE ENGINEERING LIMITED

KANE ENGINEERING LIMITED
GLENFORD ROAD, NEWTOWNARDS, CO. DOWN, NORTHERN IRELAND BT23 4AU
Tel: 028 9181 4465
Fax: 028 9181 8900
E-mail: design@kane-engineering.co.uk

COLOUR		RAL 7035	CABLE ENTRY				DESIGNED BY	D.Kane	JOB No K 4282C	DRG. No K 4282C-01
FORM			CABLE EXIT				CADDED BY	S.Gray	T5 HOTEL MAIN SWITCHBOARD NORTH	
IP RATING			MAIN BUSBAR				CHECKED BY			
ACCESS			FAULT LEVEL				DATE CHECKED			
			SUPPLY VOLTAGE				DATE DRAWN	30.08.07		
							SHEET	1 OF 41	DRG. TITLE	
03	SG	01.10.07	AS BUILT AT KANE ENGINEERING LTD				SCALE	N.T.S.	PANEL LAYOUT FRONT,SIDE & PLAN	
02	SG	31.08.07	INDIVIDUAL MCCB DATA ADDED TO THE LAYOUT				ISSUE	03		
01	SG	31.08.07	DIMENSIONS ADDED TO DRAWING							
MOD.	BY	DATE	MODIFICATION DESCRIPTION		CHECKED BY	DATE				

PDF created with pdfFactory trial version www.pdffactory.com